

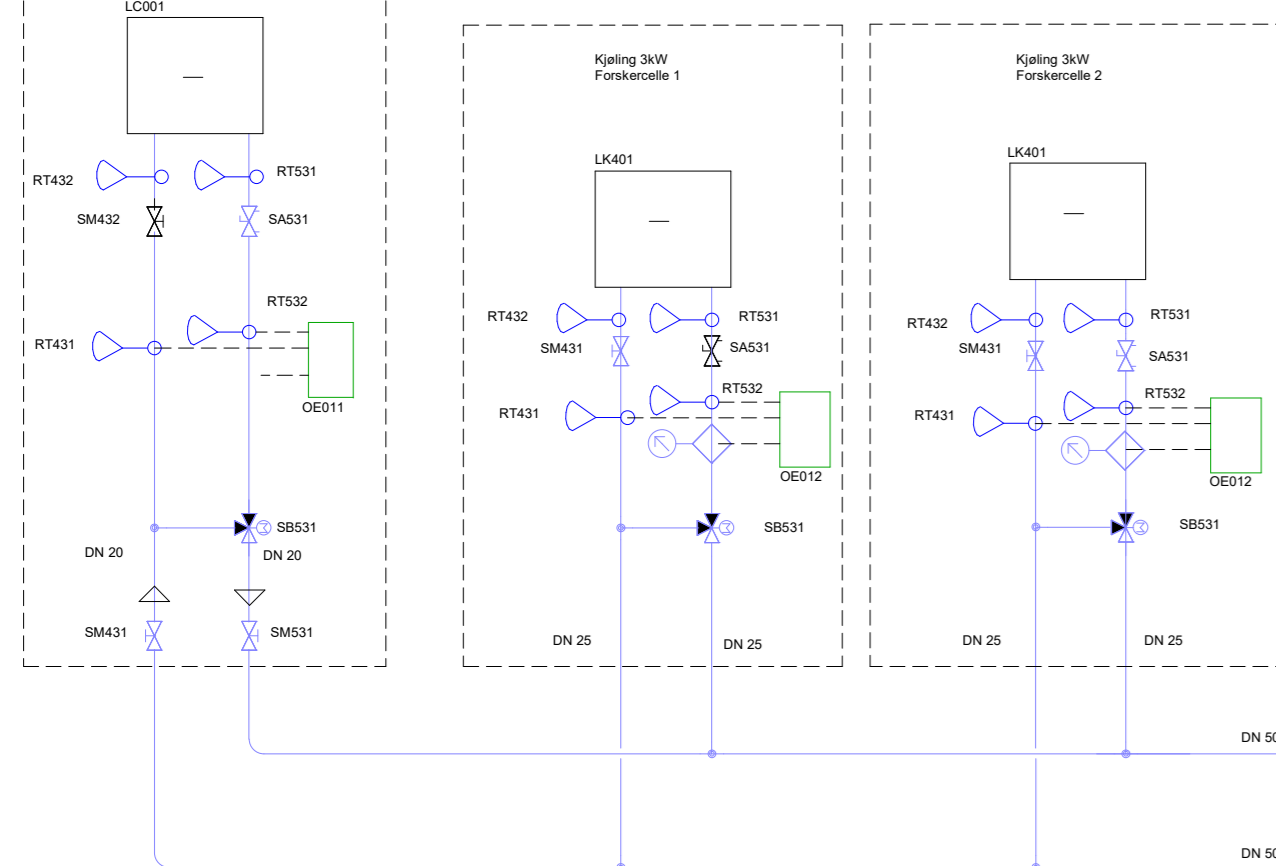


+338=370.010 +338=360.003 +338=360.004

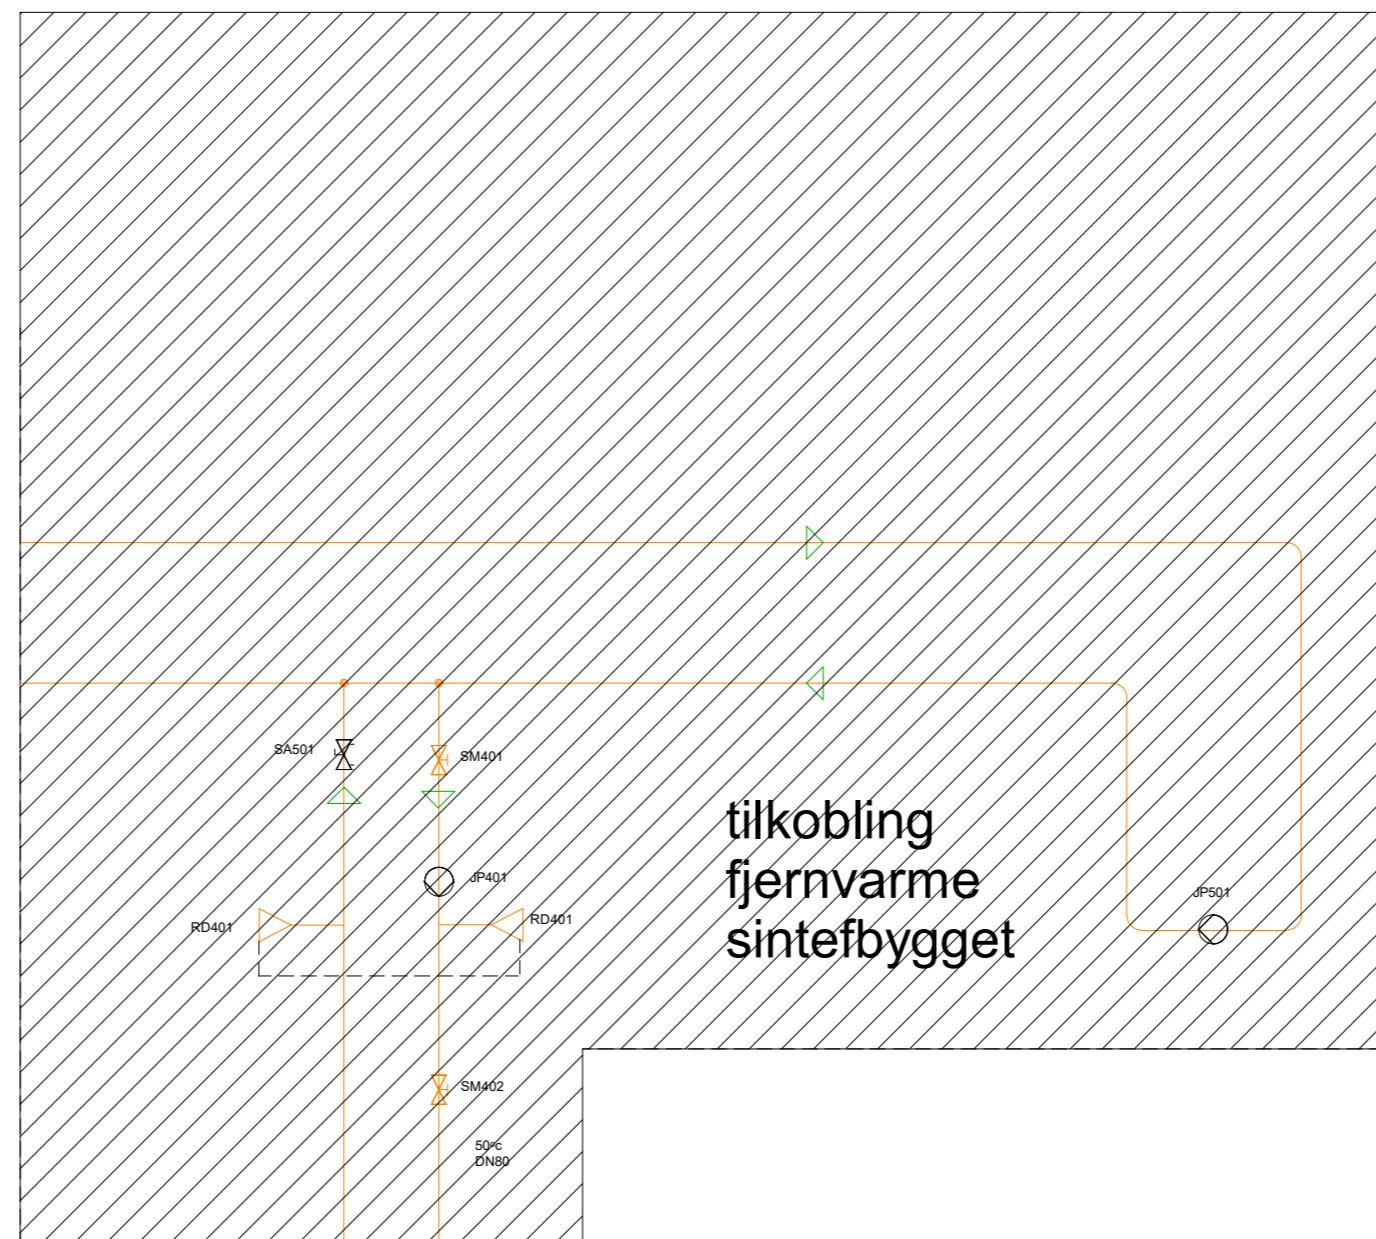


+338=370.001

Minimum 500 mm

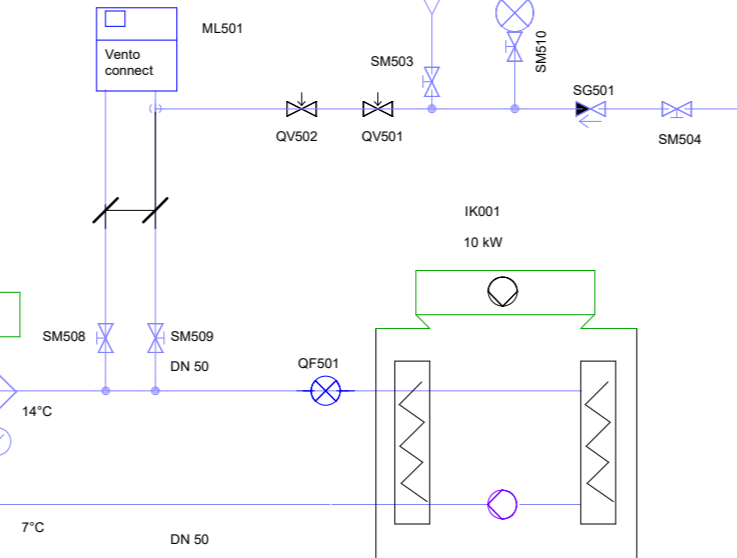


+338=360.001

+338=360.002

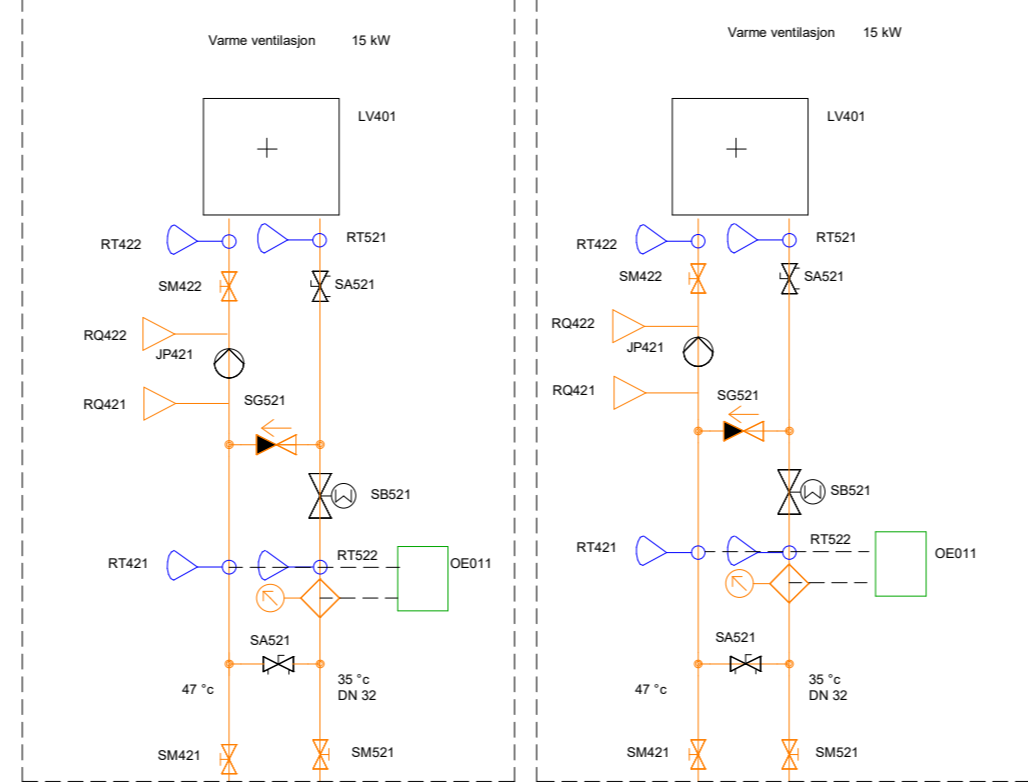


+338=310.001

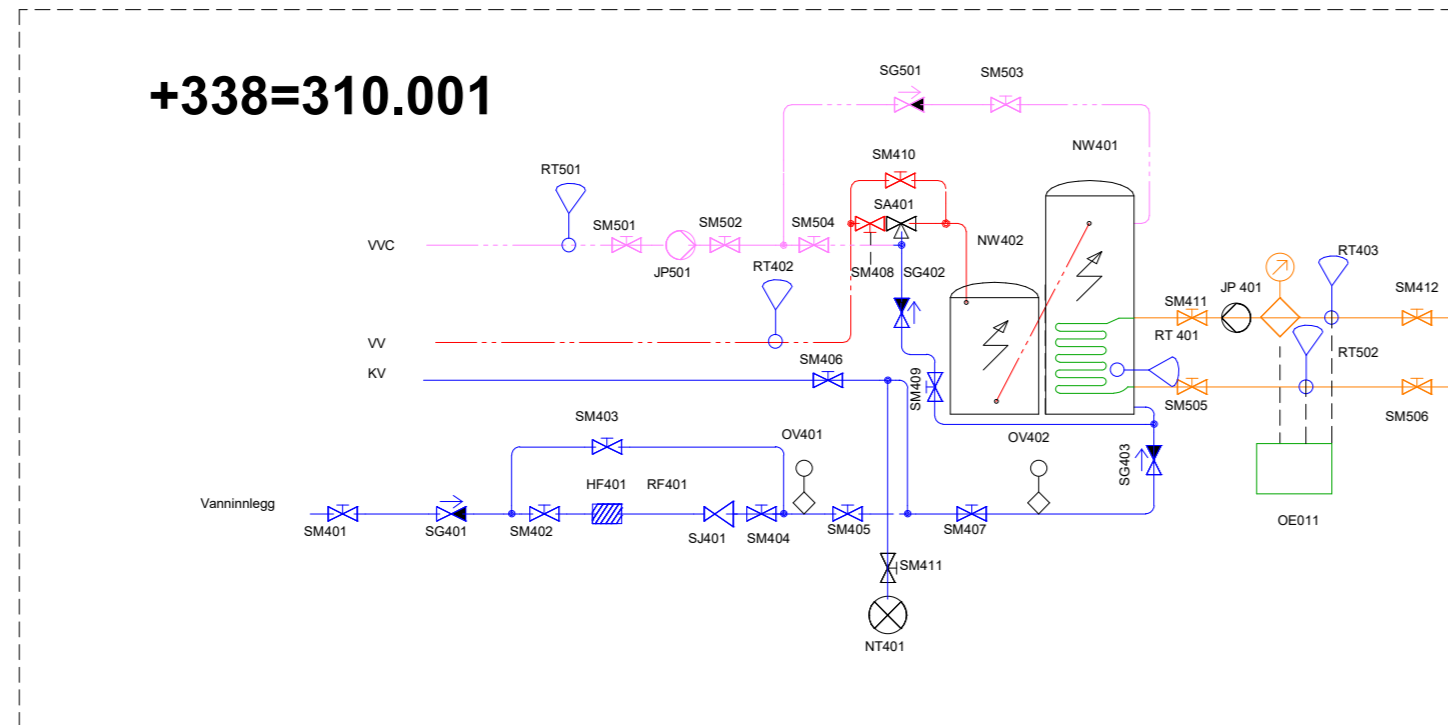






+338=320.004

+338=320.003

+338=320.001

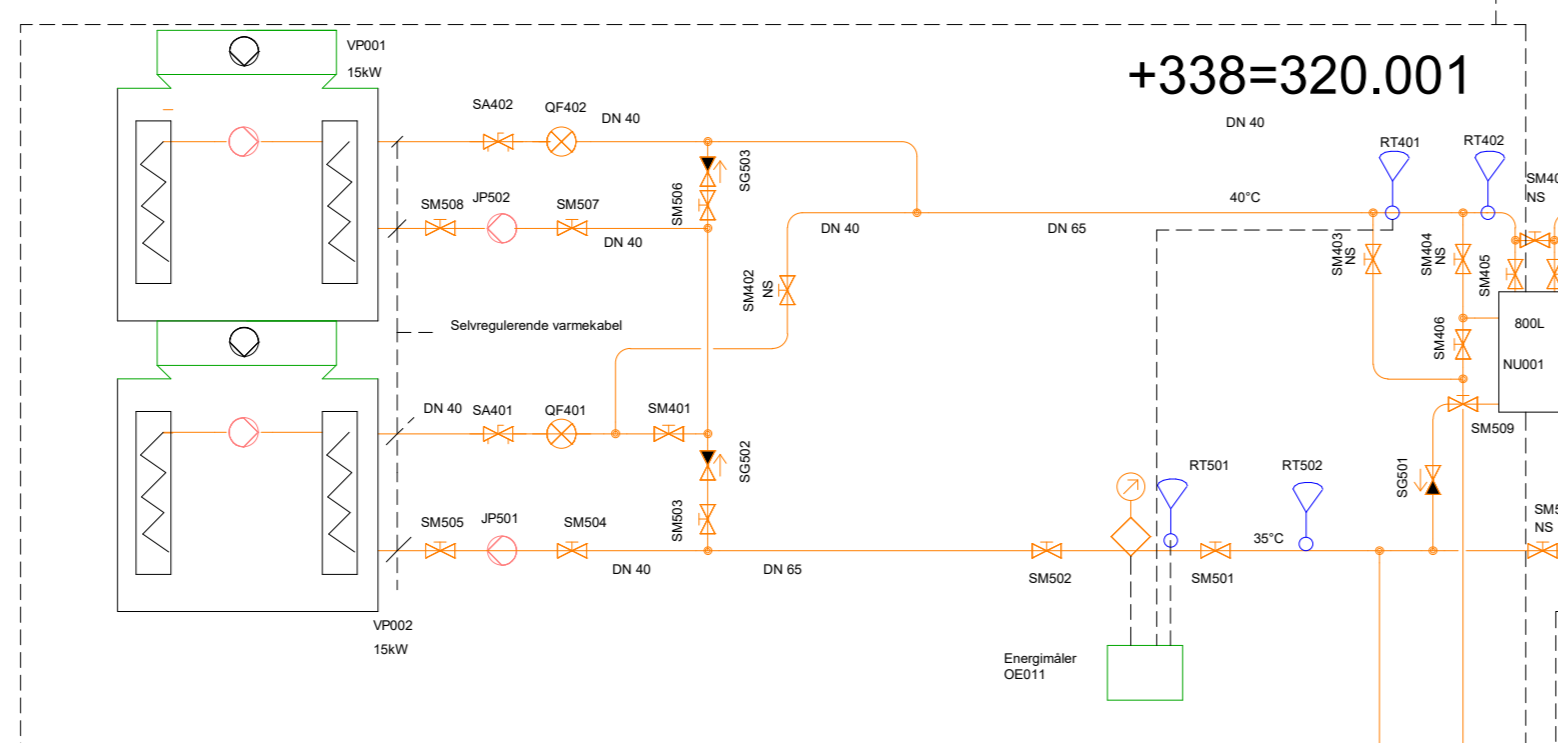

+338=320.002

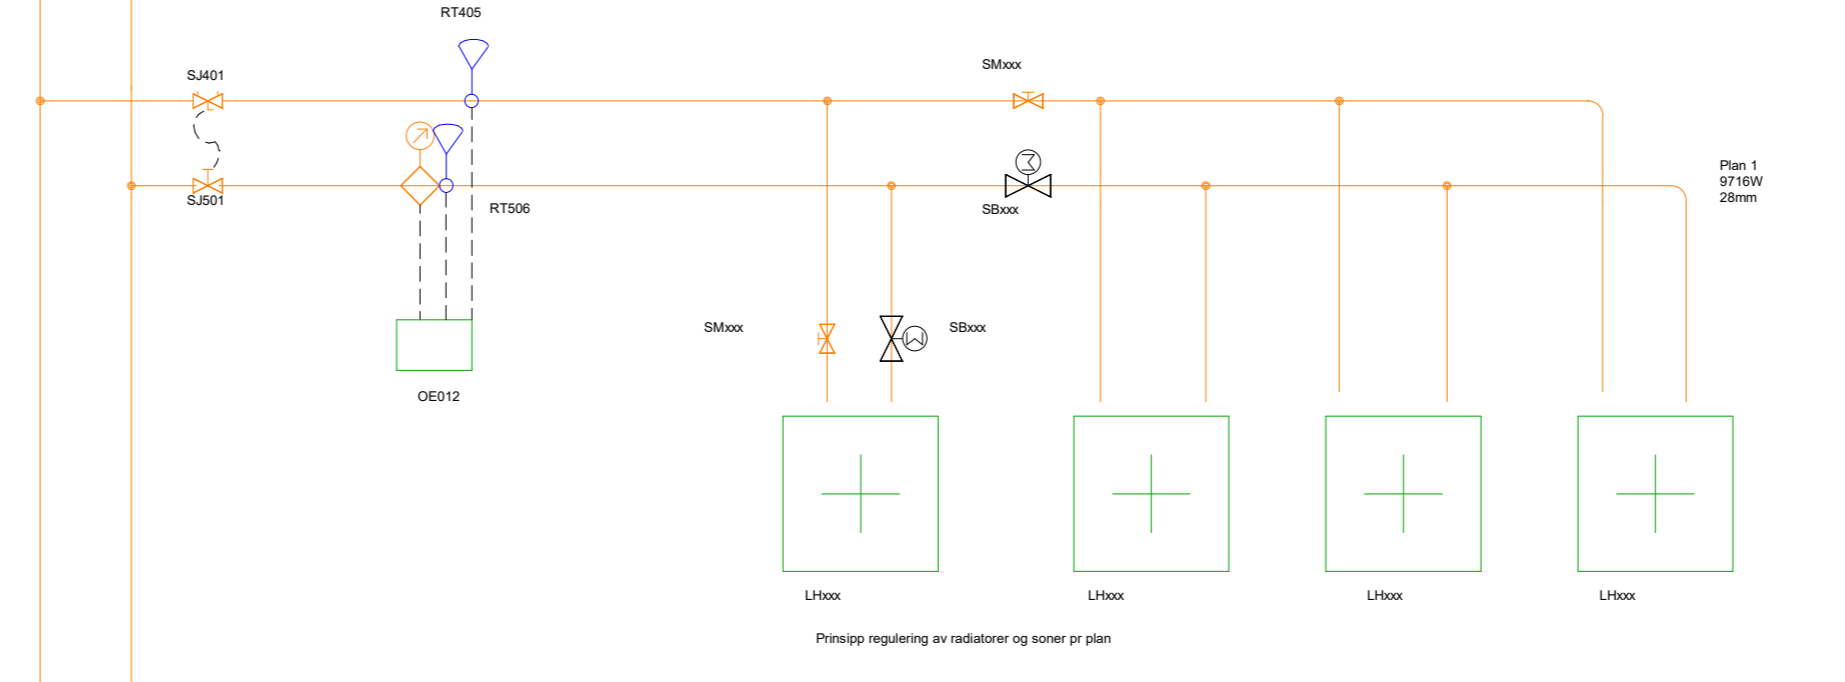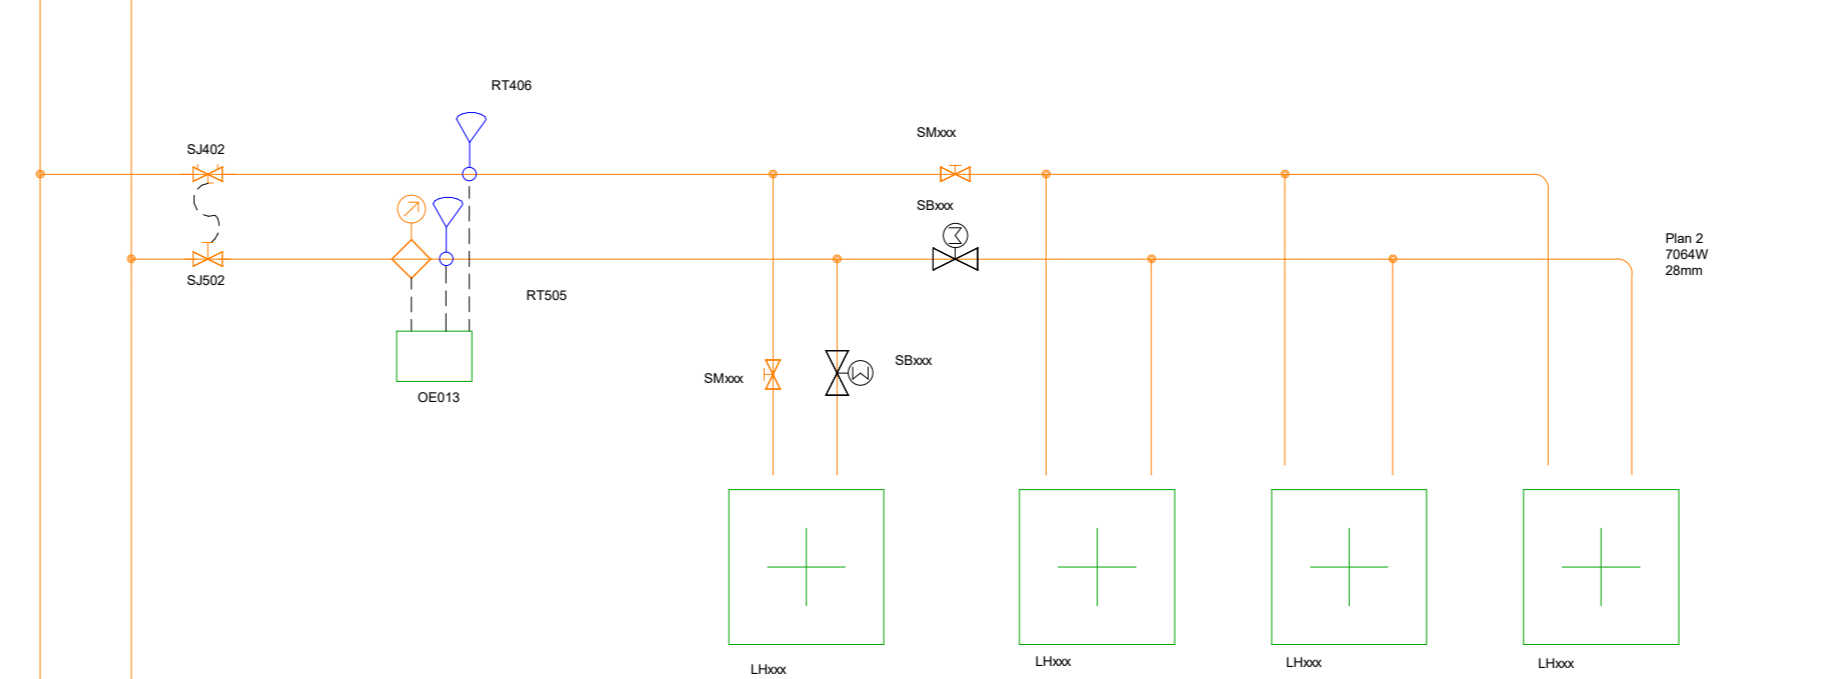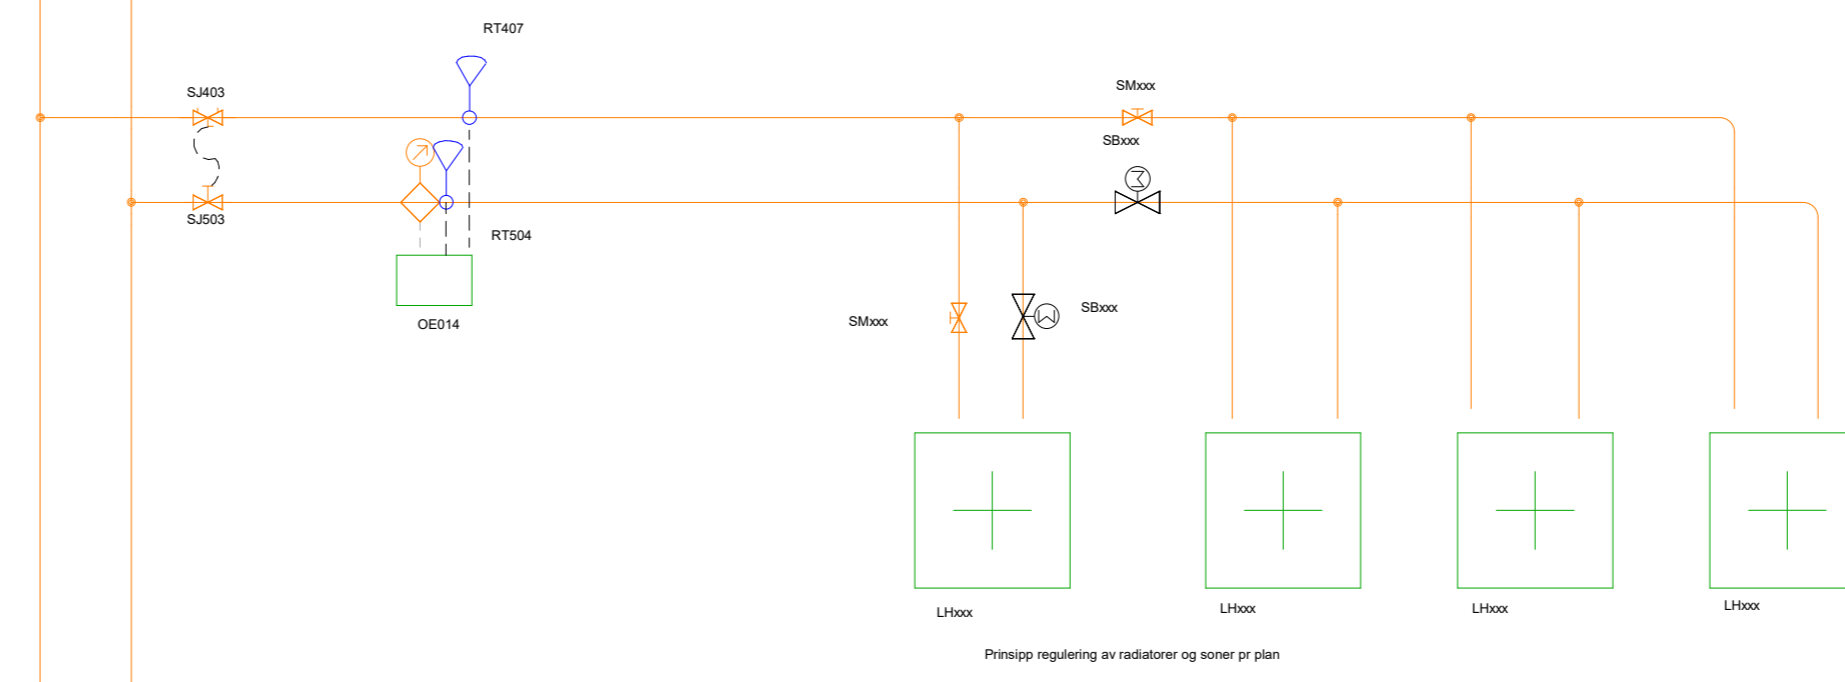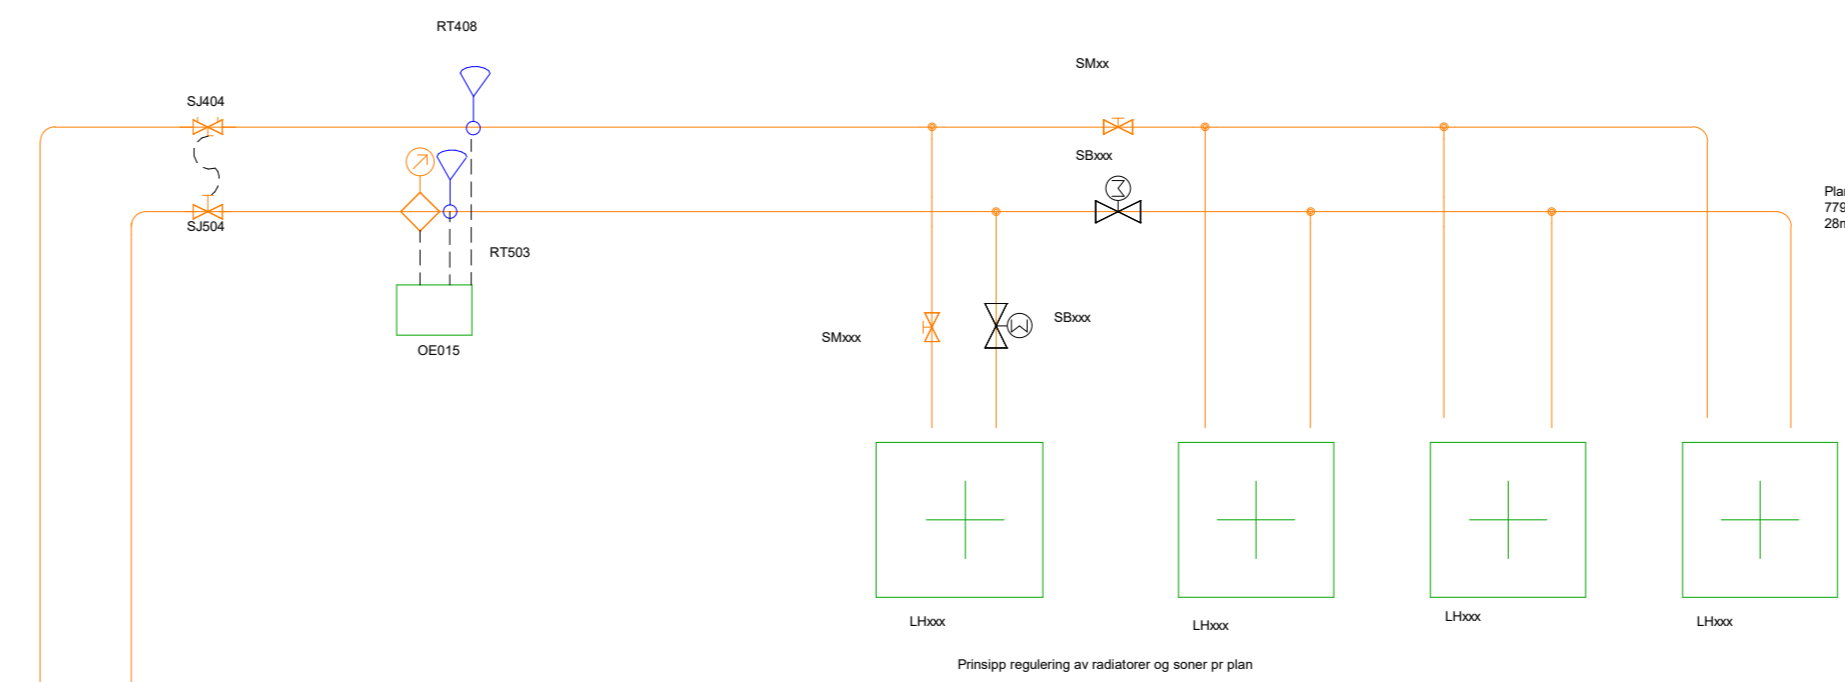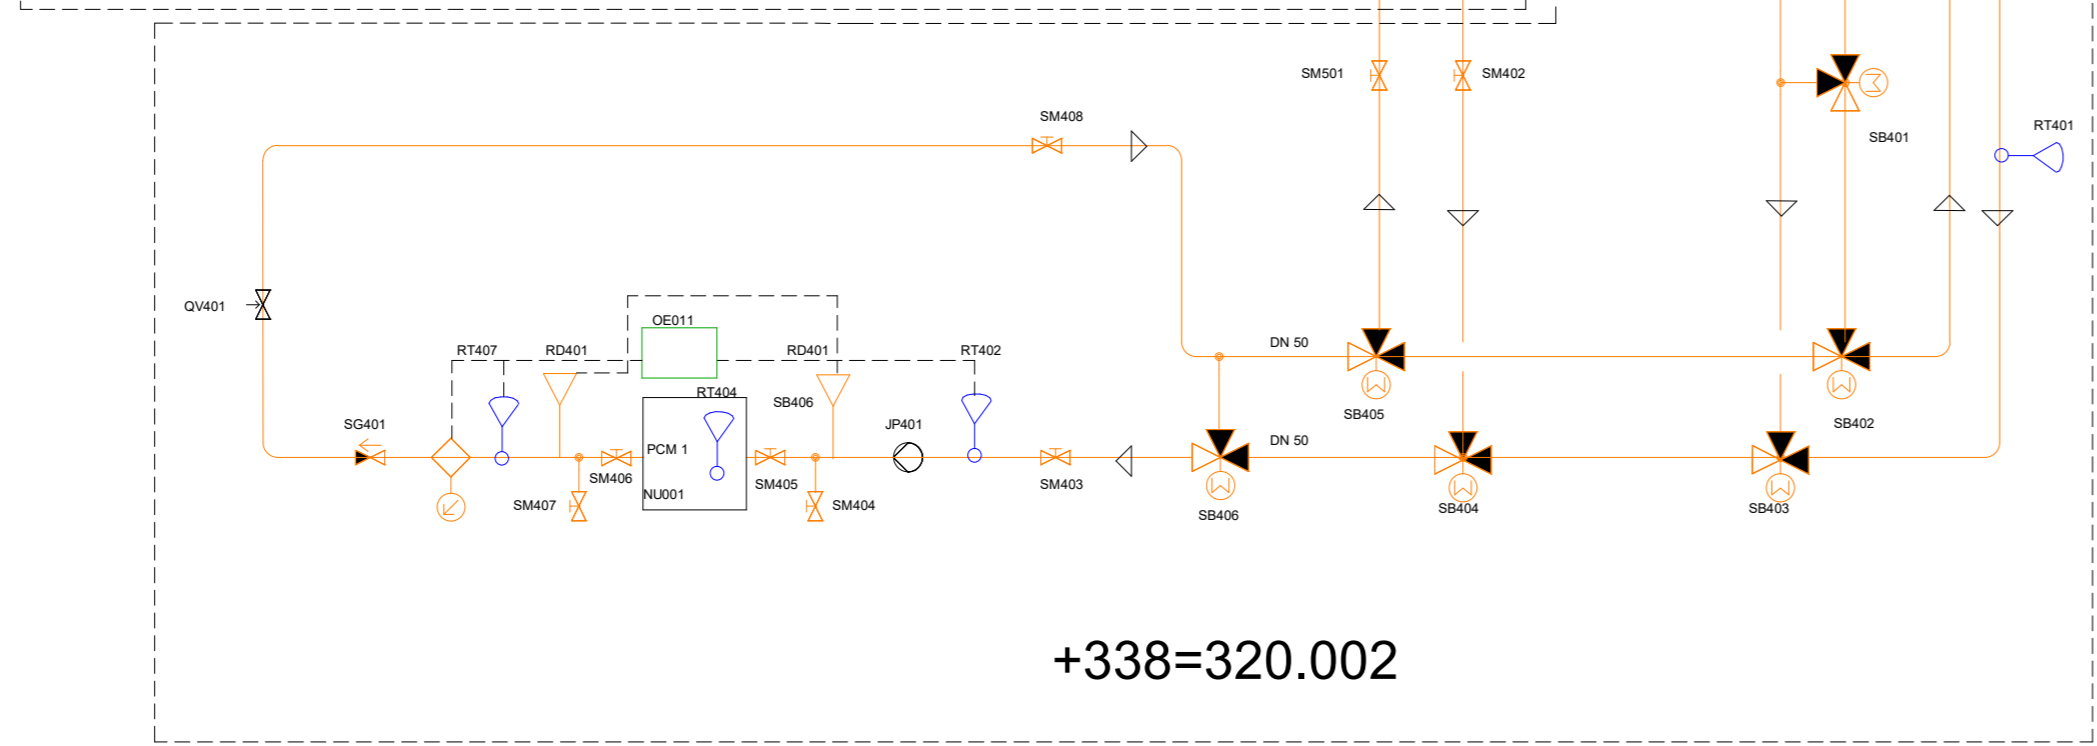


+338=360.003

+338=360.004

+338=320.003

+338=320.003

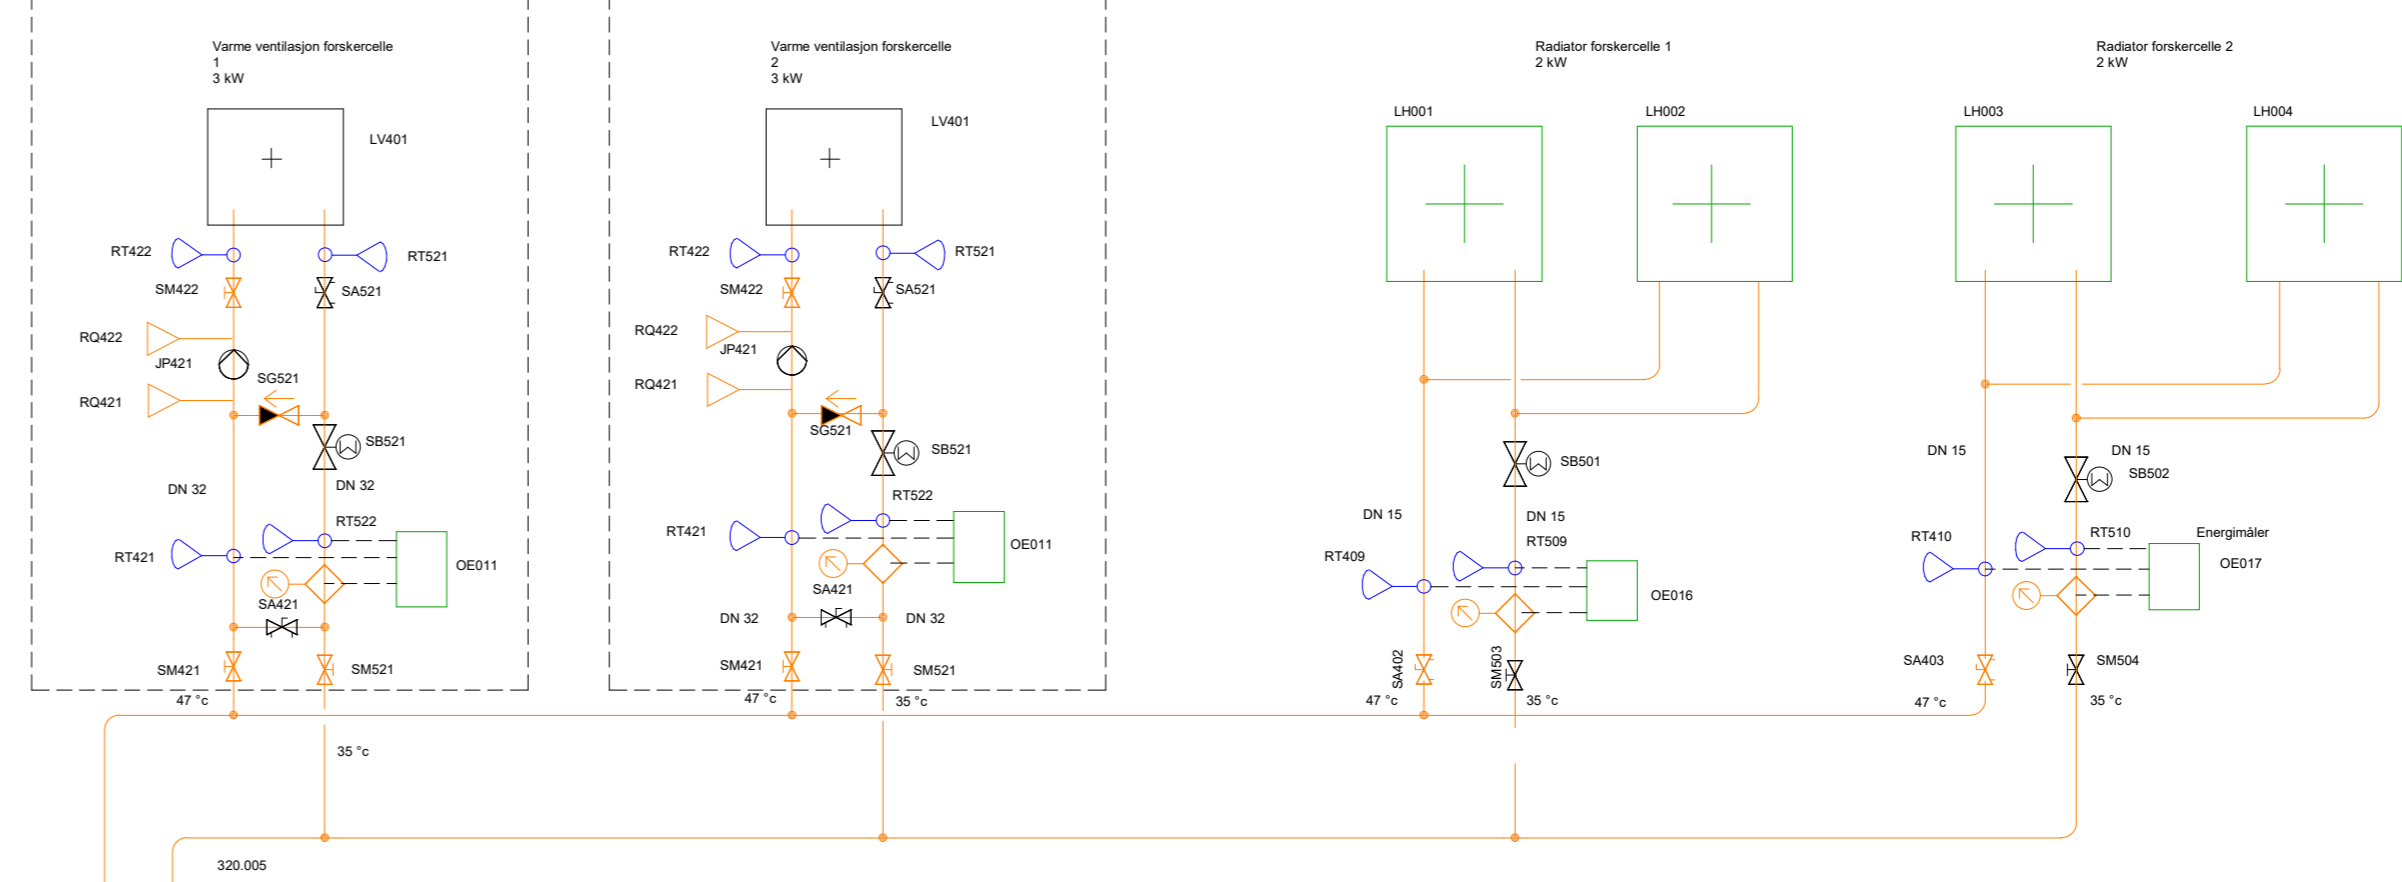

Henvisninger:

1 As-built 01.09.21 SSH

Nr. Beskrivelse Dato Sign.

Revisjoner

Tilskasser:
Veidekke

Prosjekt:
ZEB Flexible lab

Tegning:
Systemskjema Varmeanlegg

Tegnet av: SSH Tegnet dato: 21/05/19 Saknummer: 81520011 Tegningsnummer: 338001V300J001 Rev nr: 1
Kontroll av: JCH Målestokk: 1:30

